


Shannan Bee subdivision
Nordic Valley

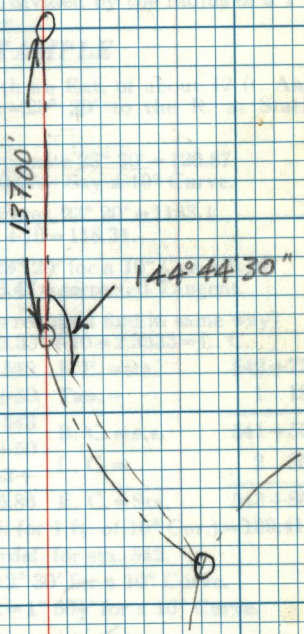

Dist to 19A = 5407.36
 Dist to $\frac{17116}{20121}$ = 2762.04
 Dist to 21A = 2257.09