


T @ 23E BS 23D

4 RT to west Fence Line	07-17-30	1332.4
4 RT to P.I. Fence COR	359-07-05	1326.5
4 RT to P.I. Fence COR	359-01-50	1295.2
South Fence Line	359-17-00	1521.8
north Fence line	358-45-00	1072.3
EAST Fence line	348-02-10	1331.7

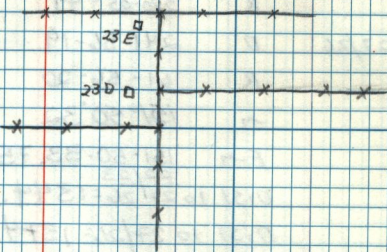

BOR - 6-3 SF-23
1954

BOR MON: 359-03-24 1282.02