


4-10-89
D. Butters
R. Balken

29 | 26 .3 1/2" Brass
32 | 33 1987
Stone Buried next to.

12

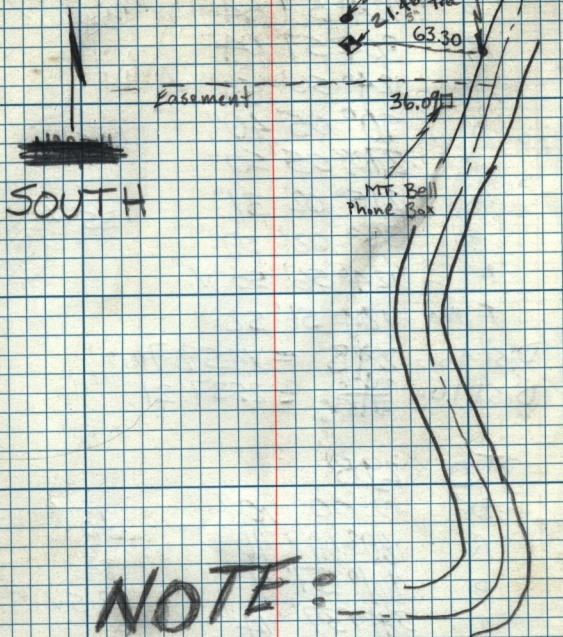

NOTE:

Aug. 4 1987 old stone was replaced by 3" Brass cap marked. old stone was buried next to Brass mon.

Dist to ~~2912~~ 5318.87
29119
291 2537.22

26.E = 889.73