

97 51 18.5 (21) x
 75 18 02.125
 94 35 02.5
 92 15 36.75




5-3-89

3" Brass D. Butters
 R. Balkan
 Center 20 T7N R1E
 1961?

(2.0)

36.00' PWR
 R/L

358 119 50
 old church 875

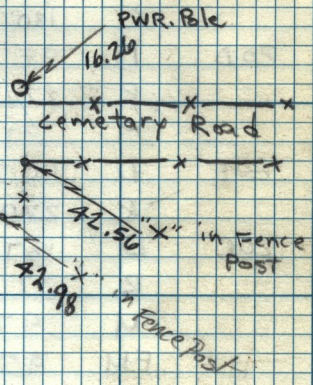

- DIST TO 29 G - 2567.60
- DIST TO 20 B - 1377.88
- DIST TO 20 E - 2460.37
- DIST TO 20 G - 981.39