


5-3-89

D. Butters
R. Balken


T 7 N
R 1 E

20 | 21
29 | 28

3" Brass
1981

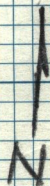

Subirrigation
willows

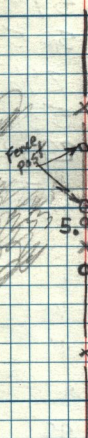

Power Lines

500 ±

Fence Post
12.25

1500 ±

Highway