


75	12	50.8
19	06	28.8
87	40	45.0
360	00	03.6

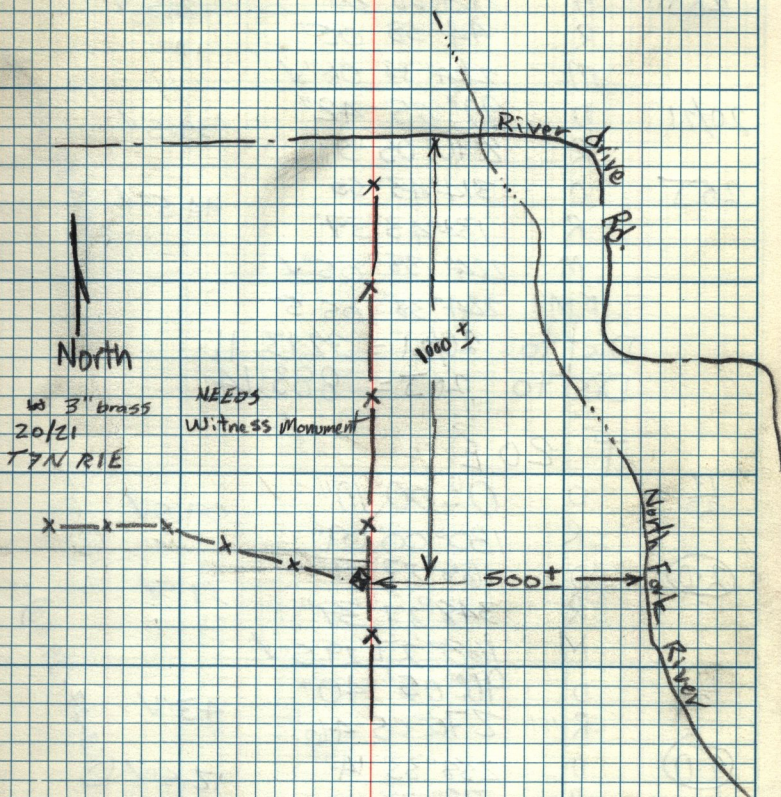

to 3" brass  
20/21  
TYNRIE

NEEDS  
Witness Monument

- Dist to 20G 1673.70
- Dist to 20I 2213.17
- Dist to 20H 800.45