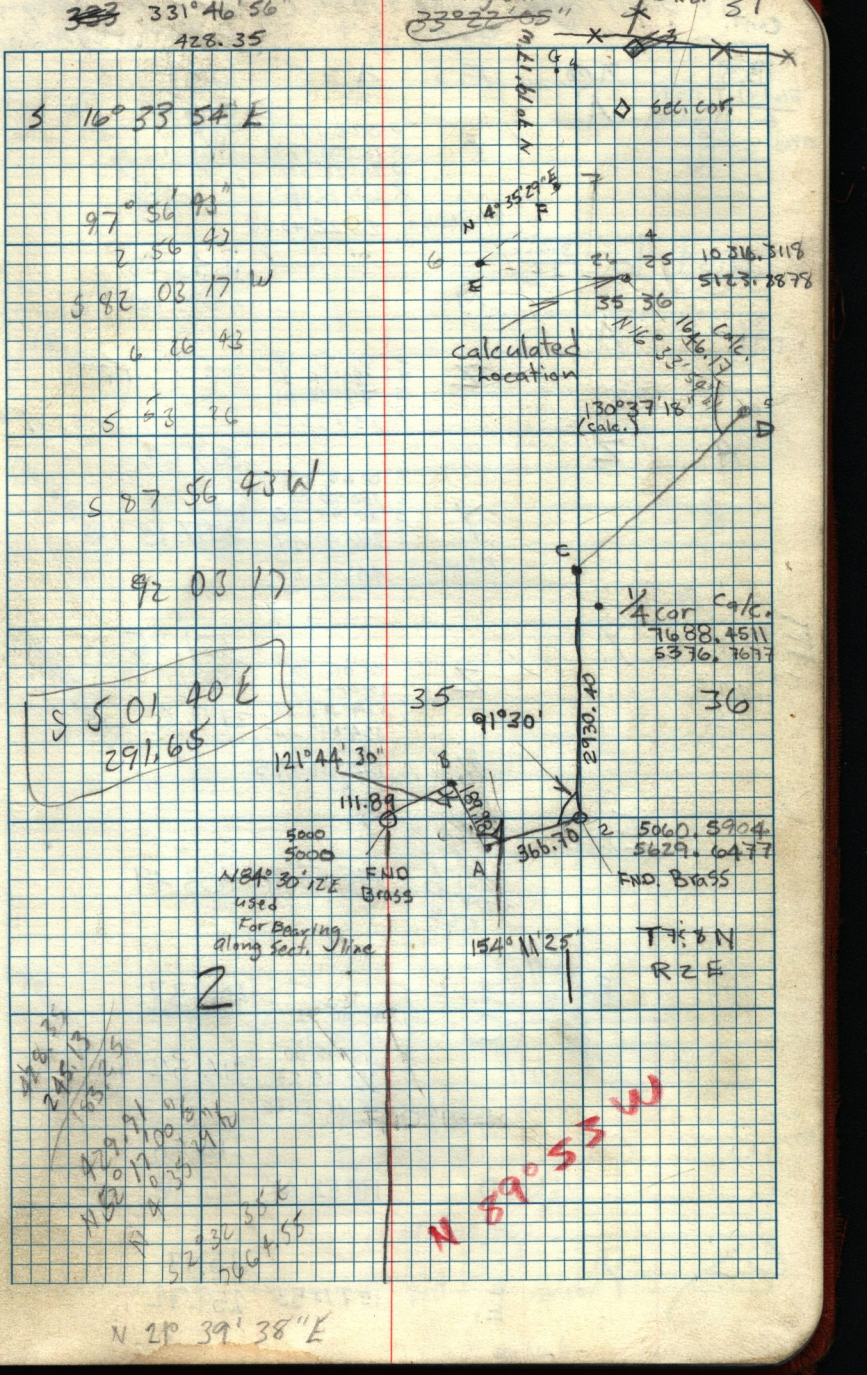

331°46'56"
428.35
33°22'05"
S 16°33 54" E
97°56'43"
2 56 43
S 82 03 17 W
6 26 43
5 53 26
S 87 56 43 W
82 03 17
S 5 01 40 E
291.65
N 70°19'17" W
N 4°35'29" E
sec. cor.
10316.3118
5123.3878
calculated location
N 16°33'54" W
1646.17 calc.
130°37'18" (calc.)
1/4 cor calc.
7688.4511
5376.7677
35
36
91°30'
2930.40
121°44'30"
111.89
5000
5000
N84°30'12"E used for Bearing along Sect. line
FND Brass
366.70
5060.5904
5629.6477
FND. Brass
154°11'25"
T7S 8N
R2E
2
N 89°55 W
N 21° 39' 38" E