

T 7 N
R 2 E 3 E




2035

808.89
1553.58


31
8-2-97

2766.43

C: (From top of hole)

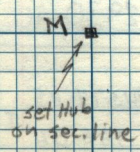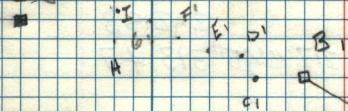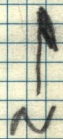

T 7 N
R 2 E 3 E

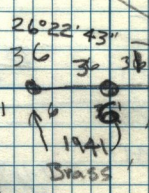

174°07'09"

East 1/4 cor 1

West 1/4 6

NOTE
A is on line
between Brass
Caps.