


18
19

R1E 4-10-89

R. Balken

52 X

Nat'l Washers
3 1/2" Brass Cap
1985
(Replaced stone)

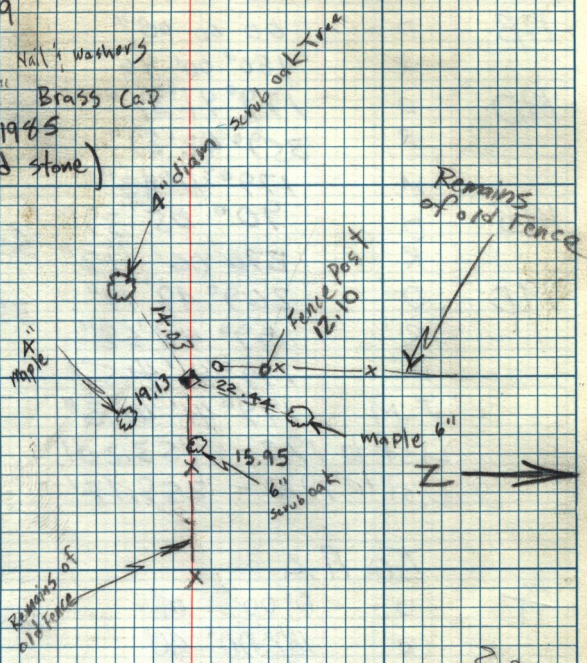

Magdon Rd. Divide

Witness man

Six Road

4300
29
N 27° 00' E