


2	11	11
146	45	35.5
131	23	16.75
81	51	10.5
360	00	02.75

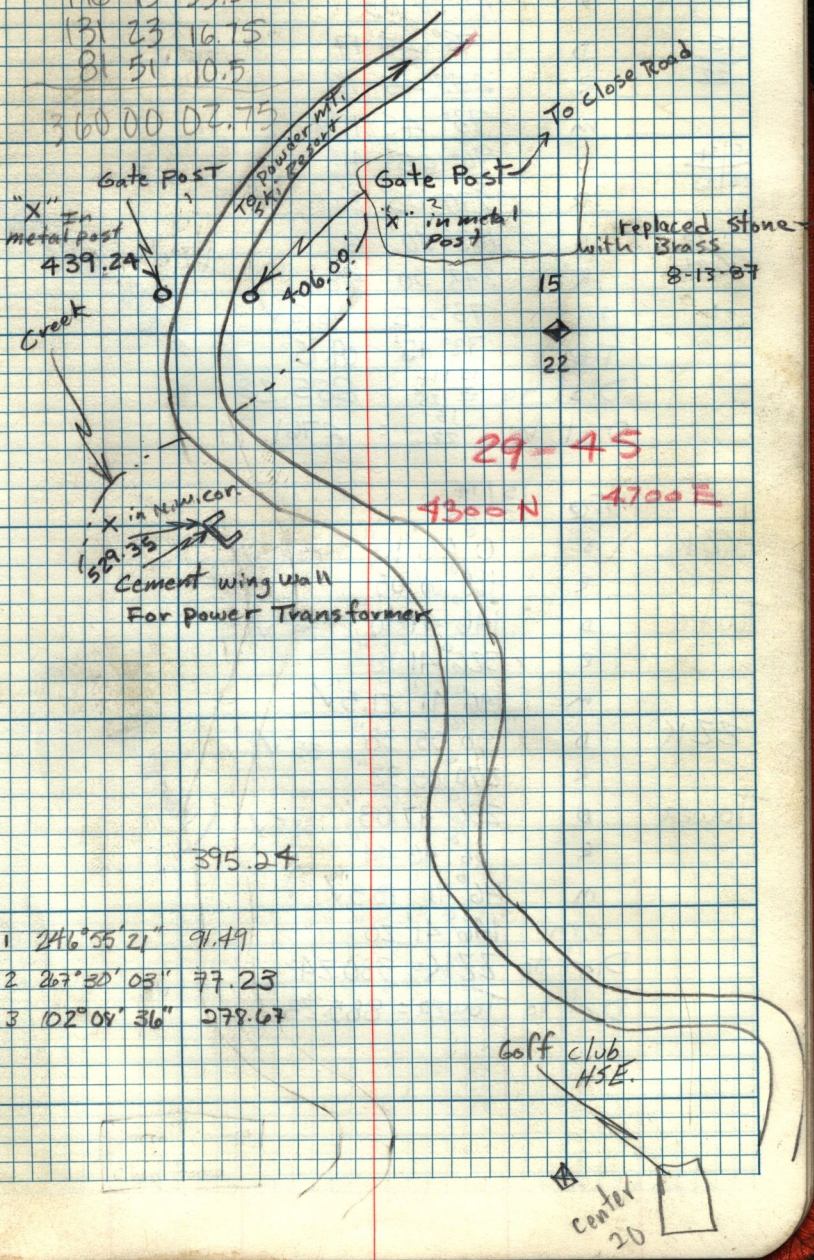

1	246°55'21"	91.49
2	267°30'03"	77.23
3	102°08'36"	278.67