
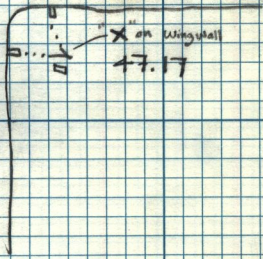
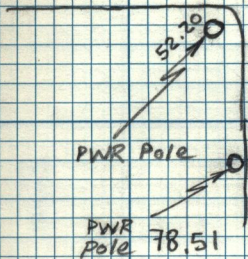


5-3-89

D Butars  
R Galten

3" Brass Weber County  
1980

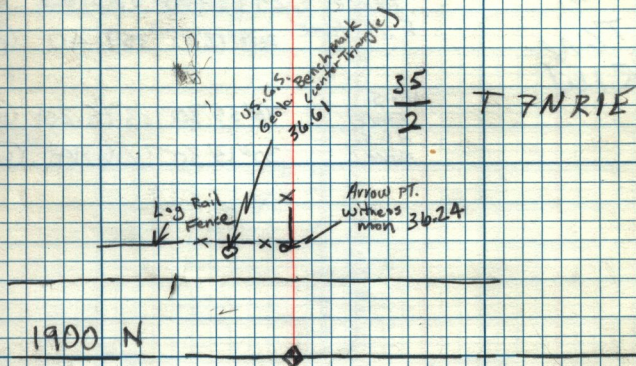

5900 F.