

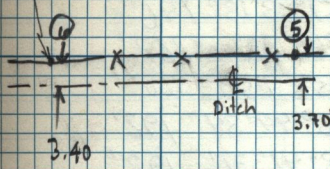


(Remains of old Post also)

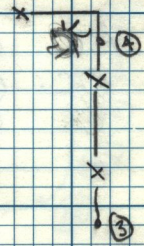

190 (Front to R.R.W. Traverse)

191

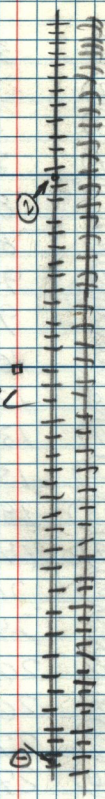

12005

12002