

Section 6


2

Fly TIE

7-3-84

BLM
MON.

31
6

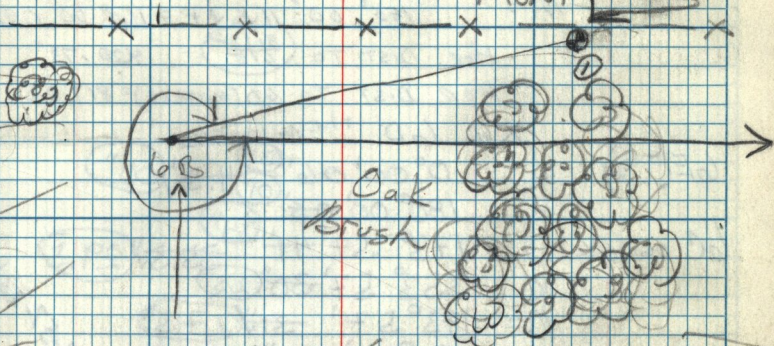

T@ 6B (scream)

B.S.

3132
65

① = $355^{\circ} 15' 24''$
761.17'

