

34.62

x 5

4-24-89


D. Bottars R. Balken

Nail & washers


6	5
7.8	

TTN. R.I.E

RR SPIKE SET IN
CONCRETE 15"
Below Road Surface

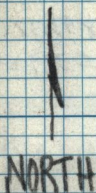

RR TIC
FNC Post
53.77

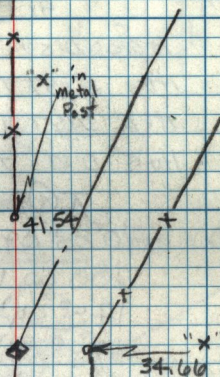

"x" in metal Post
34.66

PWR. Pole
132.84

PWR Pole
128.93