


185° 02' 52"

636.42'

Back sight
65
78

2 Fly TIES TO
GENERAL AREA

Monument NOT Found

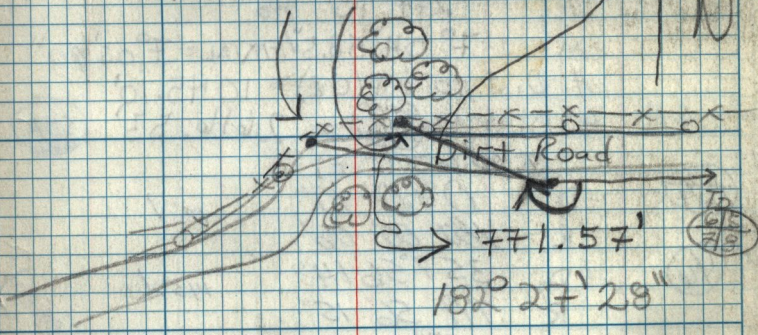

771.57'

182° 27' 28"

Back sight
rail road
SPIKE.

65
78