


79.5

76.5

T 7 N
 RIW 1 | 6 R 1 E
 12 | 7



3" Brass
1981

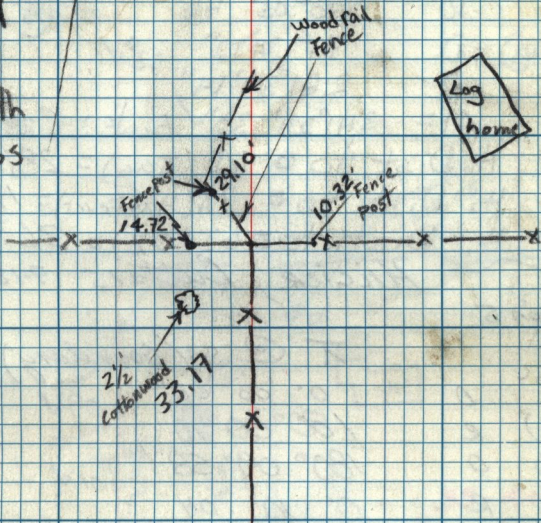

2 1/2
33.17

Fence Post
14.72

Fence

10.32
Fence
Post

Log
home

29.10