


Moved &
set 4-89
6
7

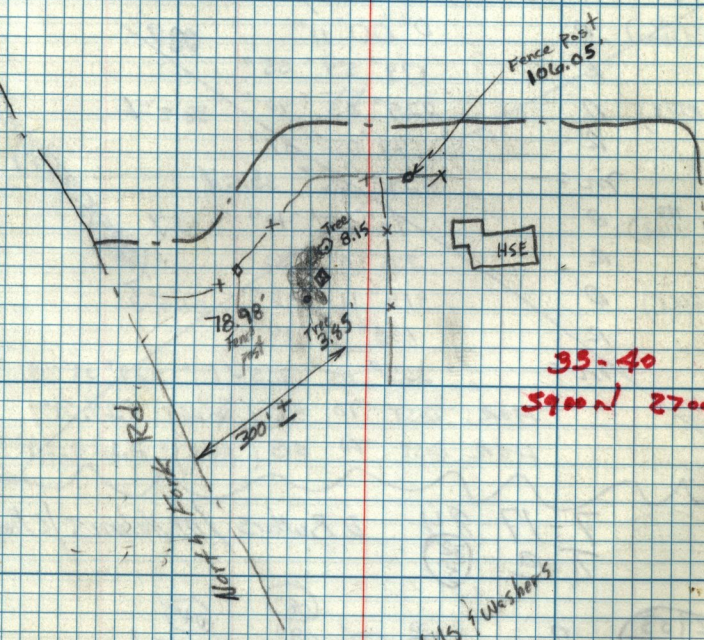

35-40
5900 N 2700 E

Nails & washers

$\alpha = 179^{\circ} 54' 56.5''$