


To Avon
Liberty Bell Subd.
STATE Rd.

1 mile



2 1/2" Hawthorne Tree 11.86
Nails & washers

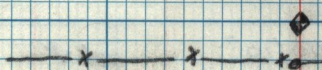

Fence Post 3.45
13.11

31-43
5100 N 3900 E

8/9

17/16

624
1544
434