


X

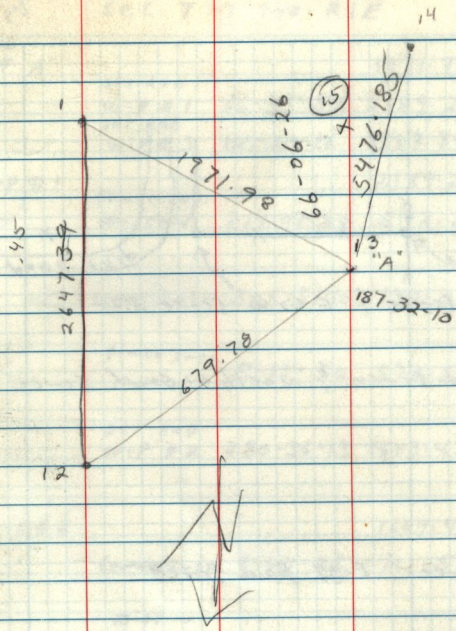

1/4 cor  
mon 7/8

RR SPIKE  
6/5  
7/8

fence Intr. 86-01-50 1274.4

fence cor 86-10-50 879.0

w-p "A"

7/8  
18/17

set hub  
w-p #5 188-14-34 591.95

1971.98

7/8  
18/17

w-p #5

E to W  
fence line 255-53-45 1162.99

591.95

fence Intr. 252-25-50 584.5

fence Intr. 165-17-50 73.0