



π @ 365 B.S. 36 C
* RT. 34° 39' 23"
Dist. 112.43'

to $\frac{36}{1}$

2-17-49
D.B.
R.B.
D.A.

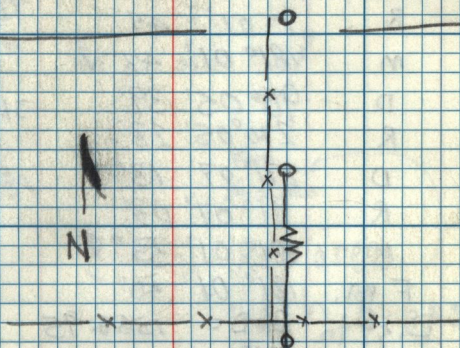

1900 N

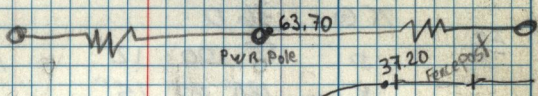

HSE

Bl. M. Brass
at Fence Cor.

1941

FNC Post
10.19

$\frac{36}{1}$