

TTN RIE
28/27

10-88

3" Brass set in 1988
replace 1/4 stone

Elder
Berry Bush

Post
x 3.22


x 2.25

Post
5.82

21.46
Nail in
Post

20-45

3100 N 4700 E

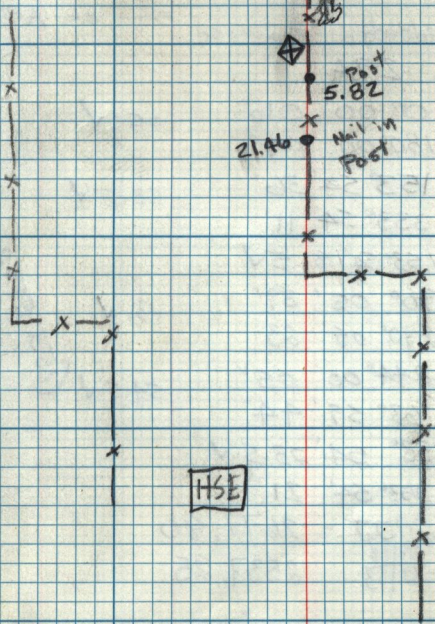

HSE

HSE

Highway 162