
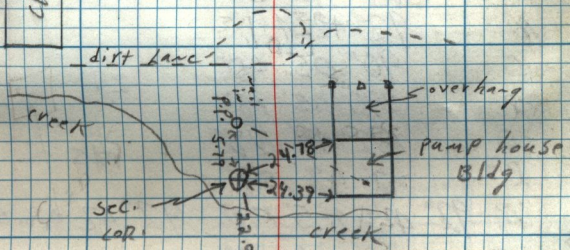
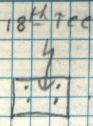
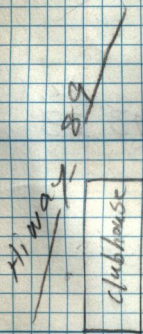


7 NO 1 W

7/9/86
Slegowski
Buttars

31/32
6/5

date: 1975
0.2' above
ground surface

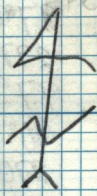

17th tee
10-12' dia
trees