

Note:


3-28-85

The $\frac{1}{4}$ corner of $\frac{33}{4}$ T7N R1W
 was FND Laying Next To the hole
 IT WAS PLACED IN. I replaced
 The conc. & Brass INTO The original
 hole and made A Tie from my
 Traverse To IT. D. Butters

(The concrete was sheared in half)
 & probably by construction. This area
 is STAKED for a subdivision



Green
 Acres
 Elementary
 School

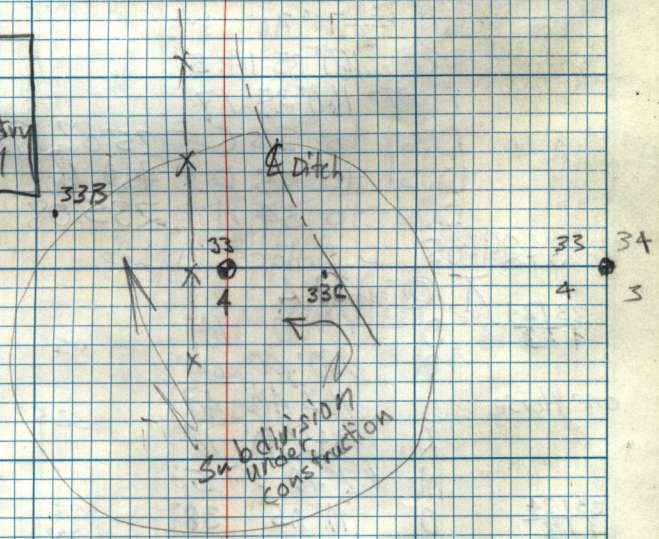

T @ 33C B.S. $\frac{33}{4} | \frac{34}{3}$

RT To Replaced Sect. Brass
 $\frac{33}{4} = 152^{\circ} 19' 40''$

Dist. = 77.43