

9-9-86
D. Butters
L. Slagowski





28	27
33	34

TTN
RIW

date: not legible!
0.2' below road surface

1050 E.

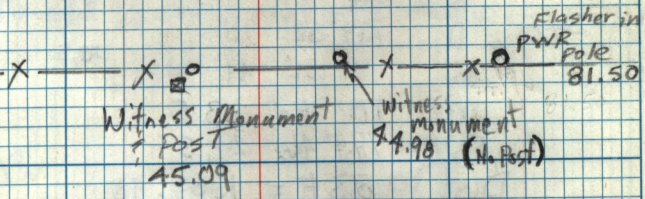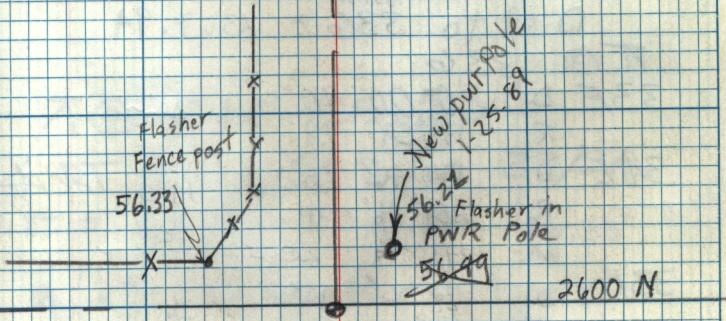

revised 1-25-89