

1-23-89

T7N R1W


24

DB R.B.B.A.

32/33

1974

3" Brass
3" Above ground

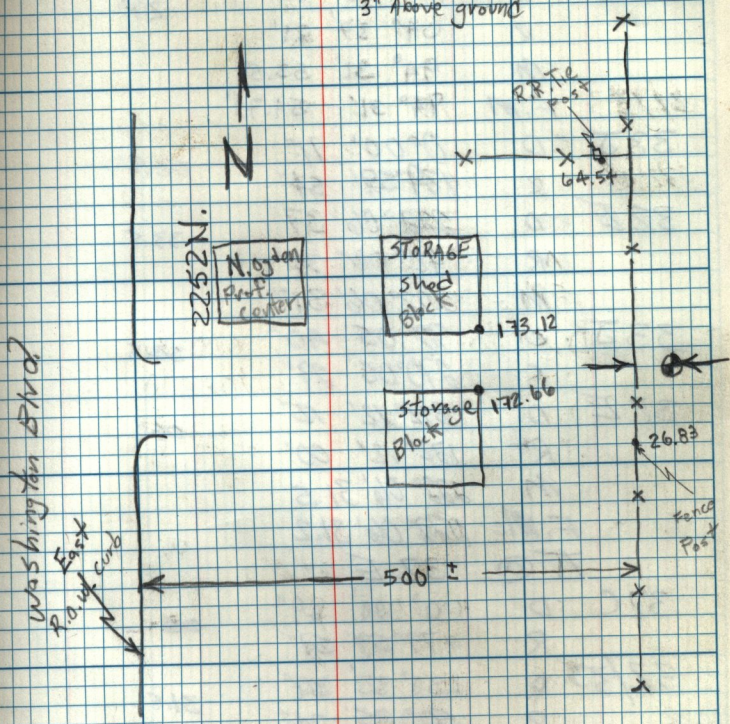

Willard
Lewis
ogden