


9/10/86

Slagowski
Buttars

date: 1970 ±
flush w/road surface

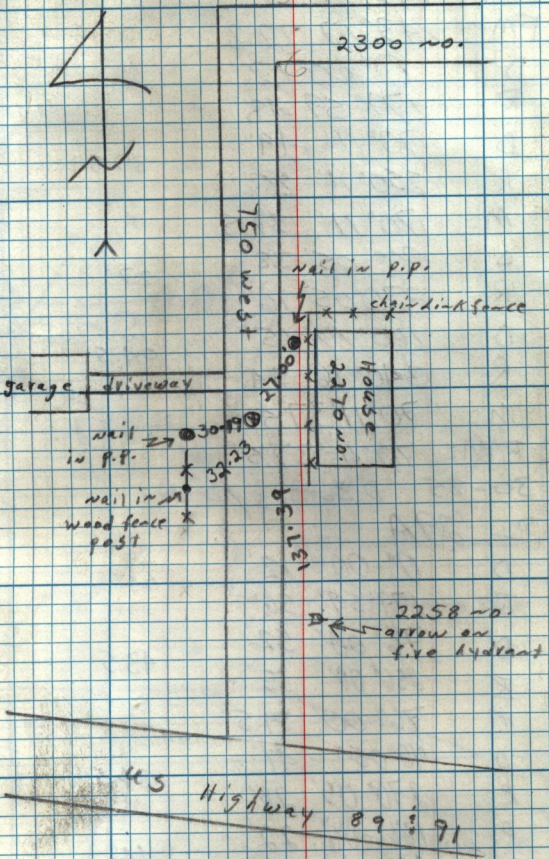

30.19

US Highway 89 & 91