


P. B. B. A. R. B

1-5-89

Witness Cor. Ties For  
 $\frac{30}{31}$

NORTH

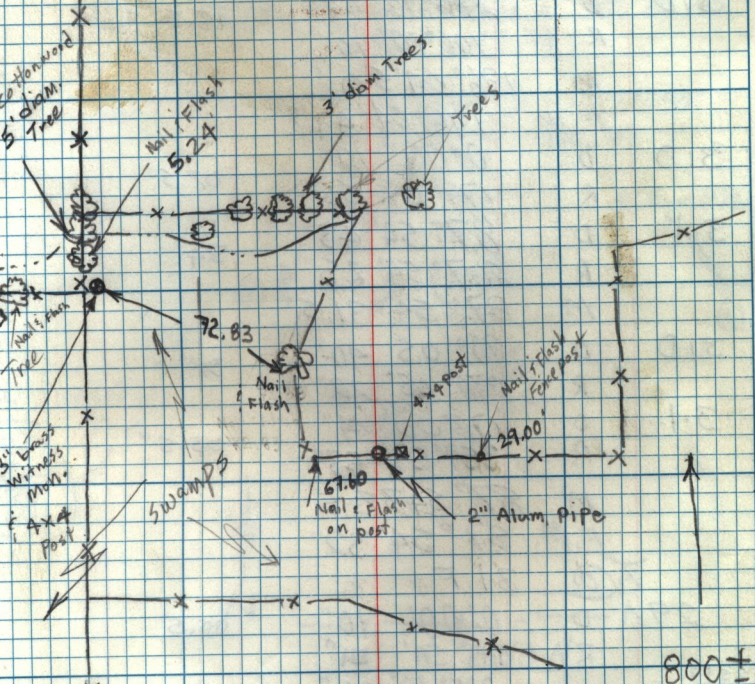

( West witness is 203' From Cor  
 South 2" pipe is 106' From Cor. )

2550 N.

750 W.