


9/9/86  
S/Agostini  
Butlers

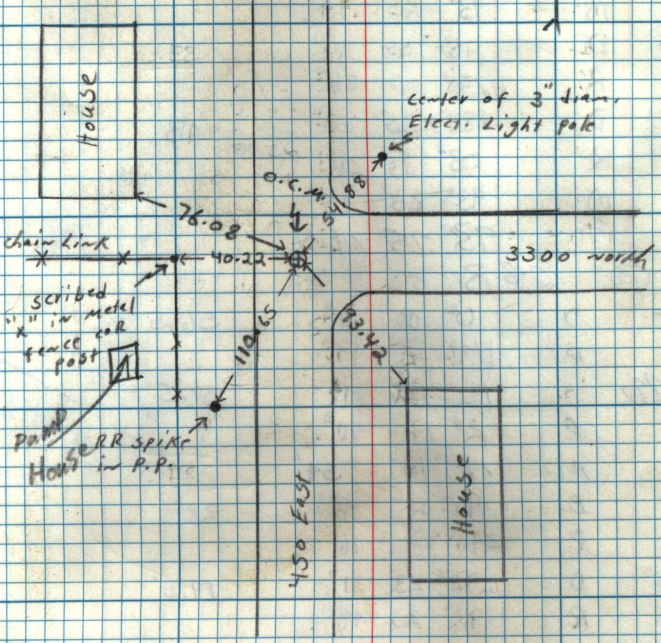

Brass Mon.  
In center of  
Intersection