


1	2	1
94	27	26
85	18	1475
88	36	00
91	38	1850
359	59	59.25

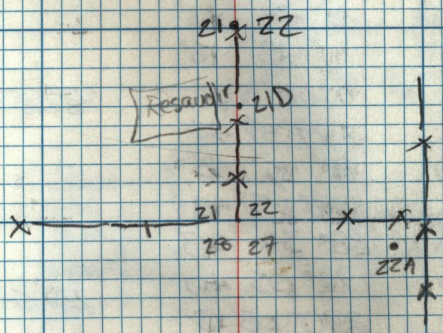

25A

27  
34

27A  
 ↑  
 26  
 North  
 Ogden  
 Pass  
 35