



21 | 22
28 | 27

9-9-86

L. Slogowski

51

date: no date
0.2' below grade surface

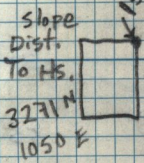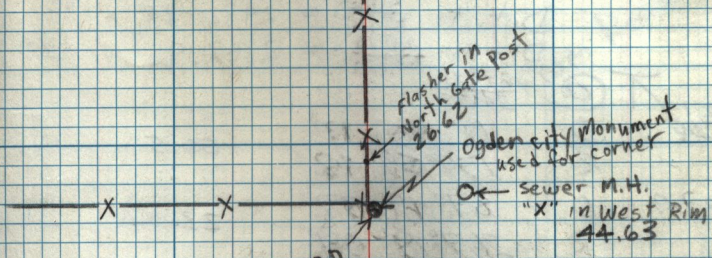

158.0

End of Street

1050 E

Needs witness monument.