



Slagowski  
Buttars

Date: 1980

flush w/ ground  
surface

21/22

54

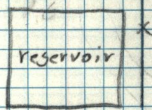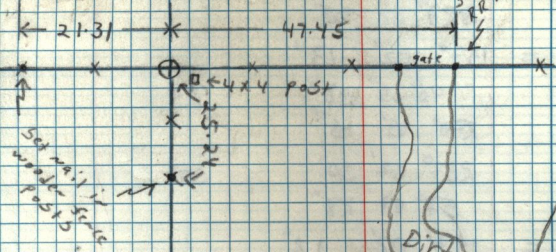


Brass Mon.

Dirt Roads



note: need  
witness cars  
set!

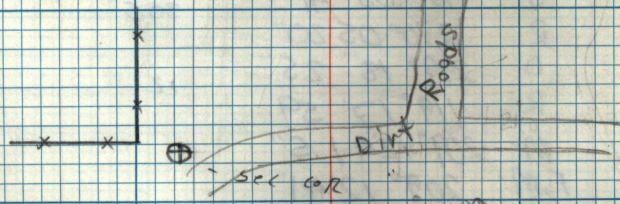

1050 East

OK - 1-25-89

225 43 18 535.67