


9-10-86

D. Butters  
L. Slagowski

18  
—  
19

T7N  
RIW

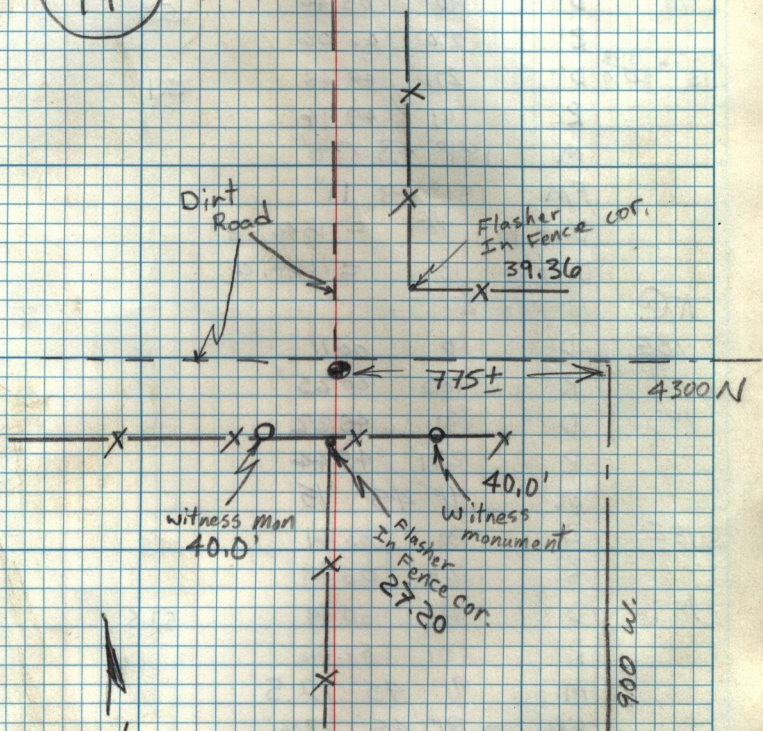

Brass mon.  
1962

10" below Road  
Surface