


- 1 tree by fence 1. 259.56'
- East tree 2. 227.63'
- 2 canal → 3. 207.56'


Pacific
Mon days
Till noon

524 - 5046 - before 10:00 on Mondays

T 7N RIW
27 | 26

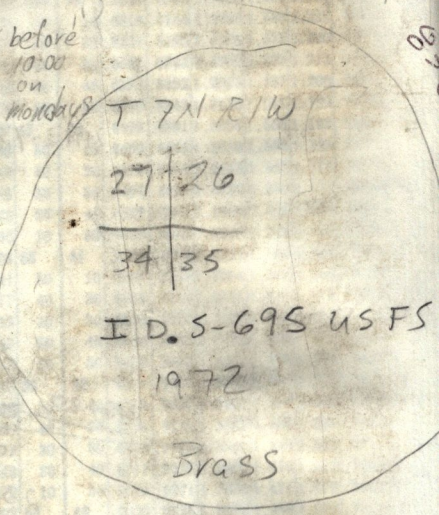

ID. 5695- USFS
1972

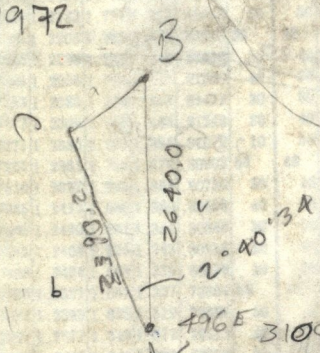

Info Photos
G.S.C. Records
compiled maps

150° 46' 21"

496E 3100 N
(John Ferguson)
says a map

Fonness

bc A

of what was done in '72

a = 249.66

Steve Barnish
Charlie Hall

B:

26 35 05