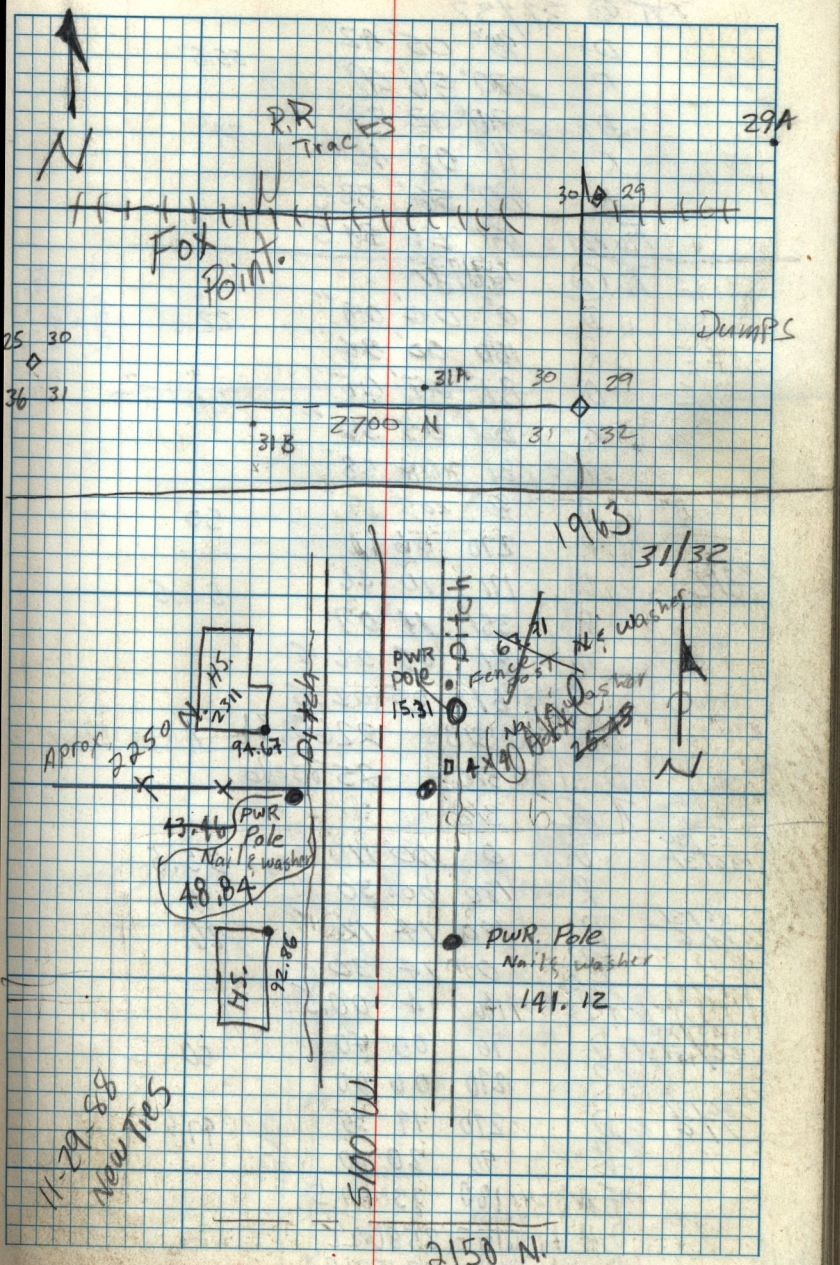
N
R.R Tracks
29A
30
29
Fox Point.
Dumps
25 30
36 31
31A
30
29
2700 N
31B
31
32
1963
31/32
Ditch
PWR Pole
15.31
Fence post
N & washer
Nail & washer
HS.
2311
94.67
Aprox. 2250 N.
Ditch
43.46
PWR Pole
Nail & washer
48.84
HS.
92.86
PWR. Pole
Nail & washer
141.12
N
11-29-88
New Ties
5100 W.
2150 N.