


W. M. 3536


$\Delta @ 35C$ B.S. $\frac{35}{2}$
 ΔRT To W.M. $\frac{3536}{211}$
 $91^{\circ} 55' 17''$
 Dist = $349.76'$

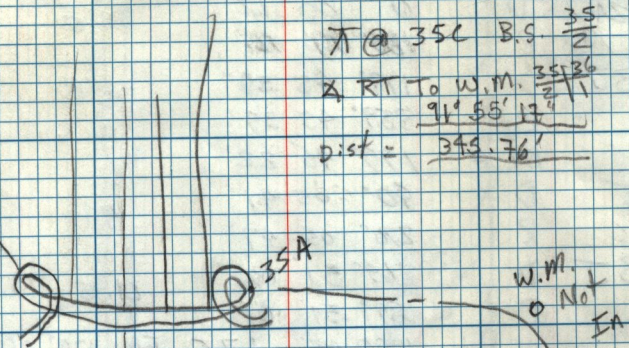

3536
2

Freeway

Freeway

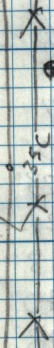

W.M.
 for $\frac{3536}{211}$

See page
 34 For
 Ties

35D

1400 M.