

T7N  
R2W

11/18/85

D. Butters / D. Lee / T Wood

$\pi @$  13 H

$\frac{13}{24}$  D 0° 00' 12" 16.5  
R 180° 00' 21"

13J D 179° 45' 38" 38.5  
R 359° 45' 39"

M = 179° 45' 22"


$\frac{13}{24}$  D 90° 05' 41" 44  
R 270° 05' 47"

13J D 269° 51' 02" 41.5  
R 89° 51' 01"

M = 179° 45' 17.5 F.M. 179° 45' 19.8"

Dist to  $\frac{13}{24}$  = 2172.62

Dist to 13J = 510.96

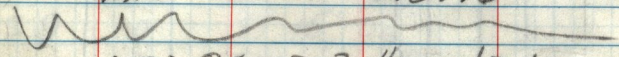

1-21-85 D. Butters / D. Lee

511099Y  
511804Y

$\pi @$  35 A

35C D 0° 00' 11" 10.5"  
R 180° 00' 10"

$\frac{26}{35} | \frac{25}{36}$  D 180° 15' 23" 23.5  
R 0° 15' 24"

M = 180° 15' 13"

35C D 90° 05' 40" 41.5"  
R 270° 05' 43"

$\frac{26}{35} | \frac{25}{36}$  D 270° 20' 56" 54.5  
R 90° 20' 53"

M = 180° 15' 13"

F.M. = 180° 15' 13"

Dist to 35C = 1845.56 Aver. = 1845.595

Dist to  $\frac{26}{35} | \frac{25}{36}$  = 3834.83

$\pi @$  35 D

Dist to 35C = 2309.50 Aver. = 2309.53

Dist to 36B = 2049.04 Aver. = 2049.05

cont.