


T@

5.04' to Great Basin rail & Washer
(South)



T@

5.06' to Great Basin rail & Washer
(South)

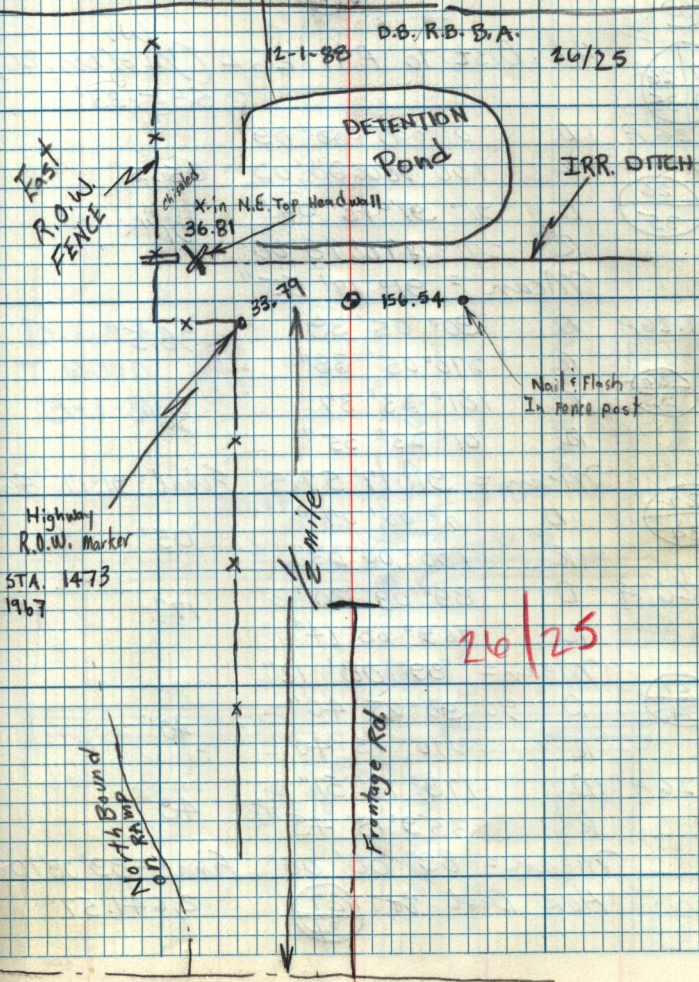

26/25