


0-21-05
7.7N. R.2W.

(16)

A.C.

(27/26) (Hub)

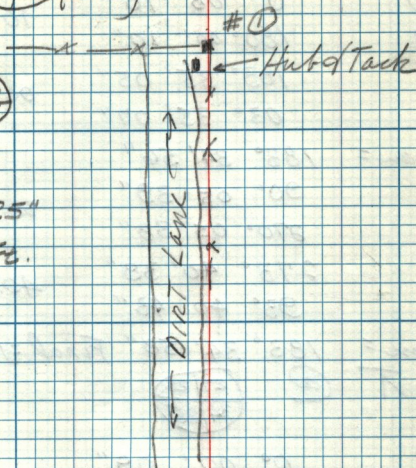

B.S.

(27/24)
34/35

#1

205° 41' 25"

13.0' FB.