

12-14-88


D.B.  
P.A.  
T.B.

3" Brass  
1962

R1W

R2W 13/18

North

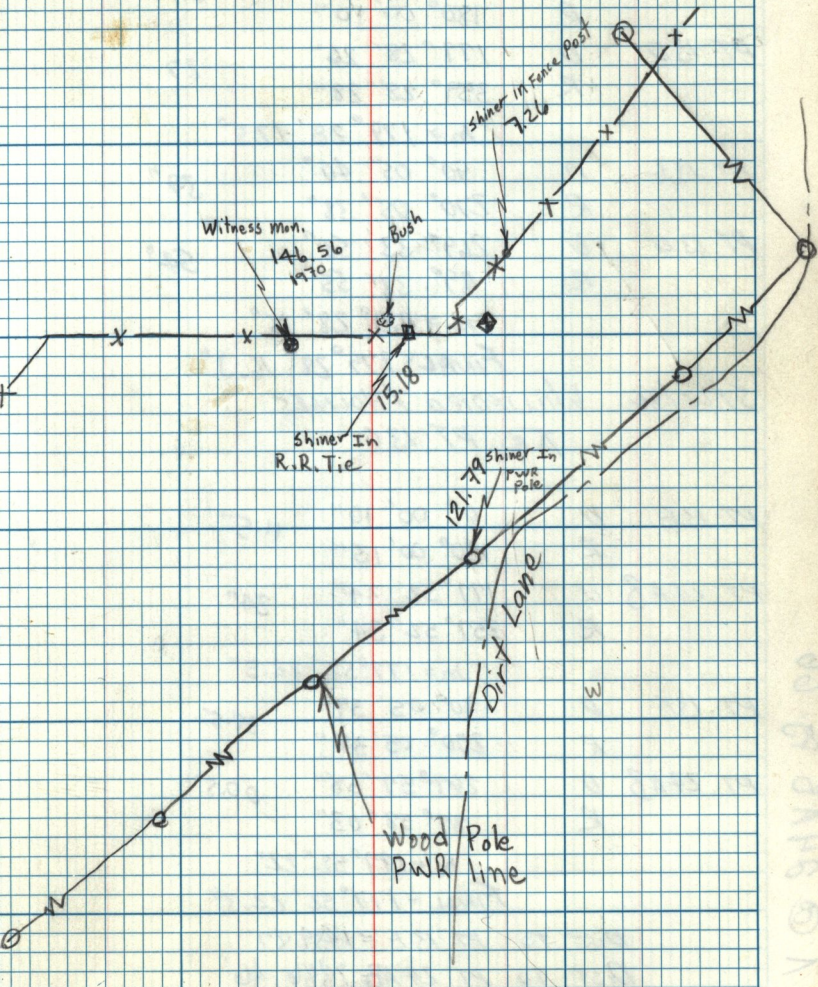

NO 9482 20