D. Buttars
A. Favero
5-13-86
T7N R2W

10 11
15 14 N

Canal R.O.W. ℄
Fence

Ties For 1/4 15/14
on Fence

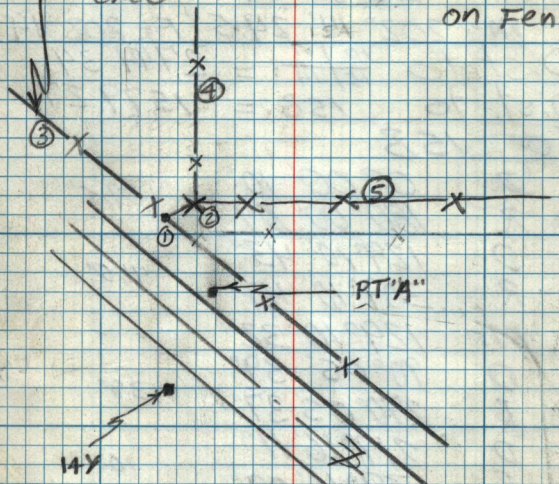

T @ 14Y BS 15/22 | 14/23
℄ RT To A = 156°00'35"
Dist to A = 195.88

T @ "A" BS 14Y
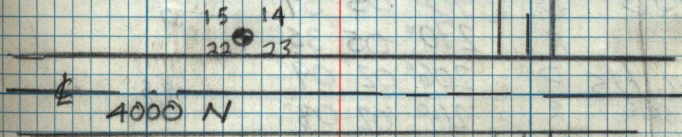
① ℄ RT 174°28'10" Dist 157.82
② ℄ RT 183°35'00" Dist 170.27
③ ℄ RT 163°01'50" Dist 243.07
④ ℄ RT 191°35'44" Dist 268.66
⑤ ℄ RT 220°15'35" Dist. 162.75