


12-1-88

D.B. R.B. B.A.

64

FROM (2.4) TO 2 1/2 25 = 2628.88 approx 23" west for LINE ON WIT MOM.

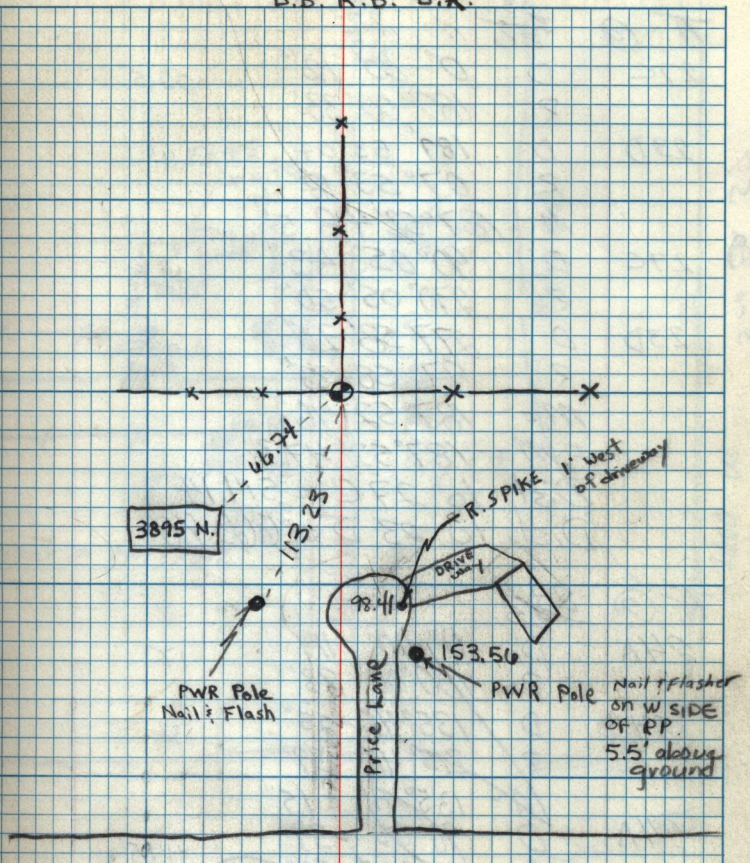

Pleasant View drive



NORTH

3" Brass P.V.C. Pipe
1980 (2.4)