


3-04-85


(71)

Weber Co. 1972

$\frac{26}{25}$   
 $\frac{35}{36}$

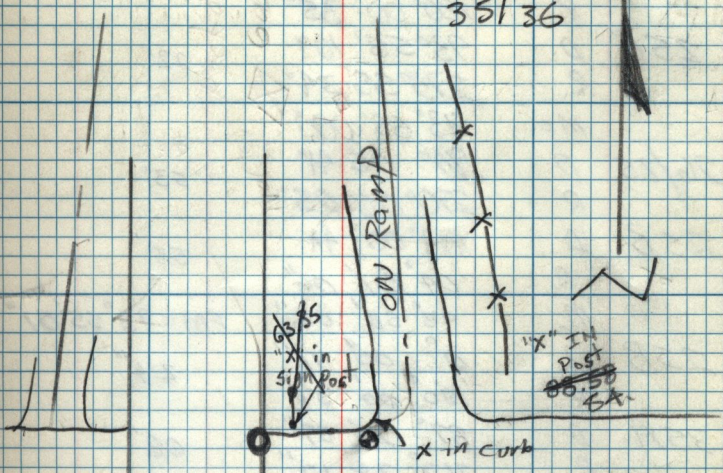

2700 N

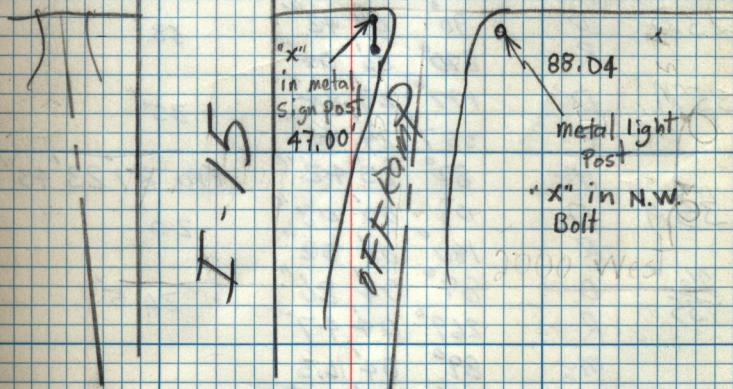

New Ties  
11-21-85