


(22)

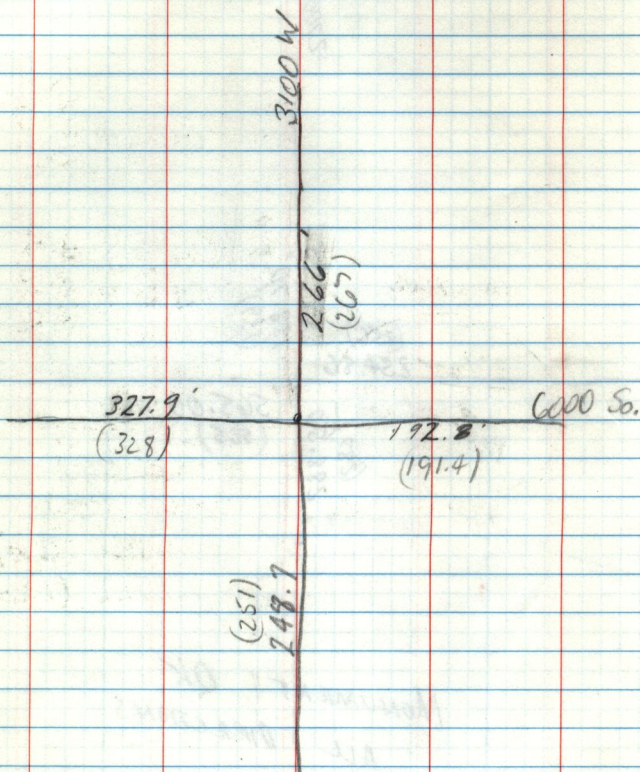

OK ALL DIRECTIONS