


12/2/84. Whittier / 10000
2801
3
19/20

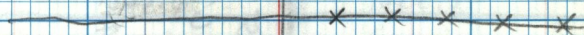

NO FENCES TO CHECK
BUT CORNER SHOULD
FALL IN THE MIDDLE
OF A NORTH-SOUTH
ROW. IT ACTUALLY
FALLS A GOOD 20'-25'
EAST OF ROW CENTER

MONUMENT TO SOUTH IS ON
EAST R/W FENCE EXTENDED