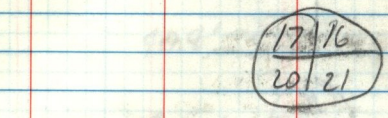
17
16
20
21

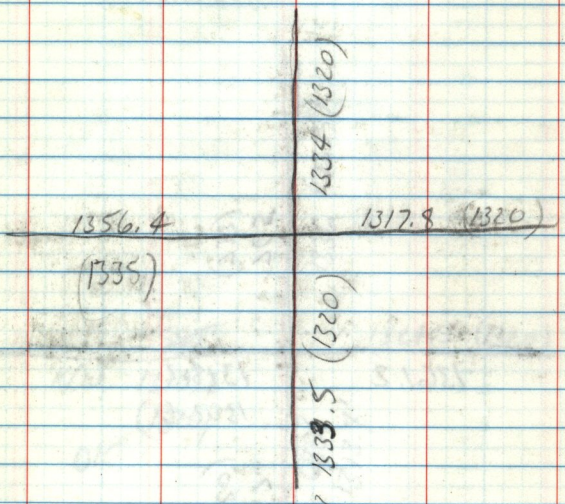
1334 (1320)
1356.4
(1335)
1317.8 (1320)
1333.5 (1320)