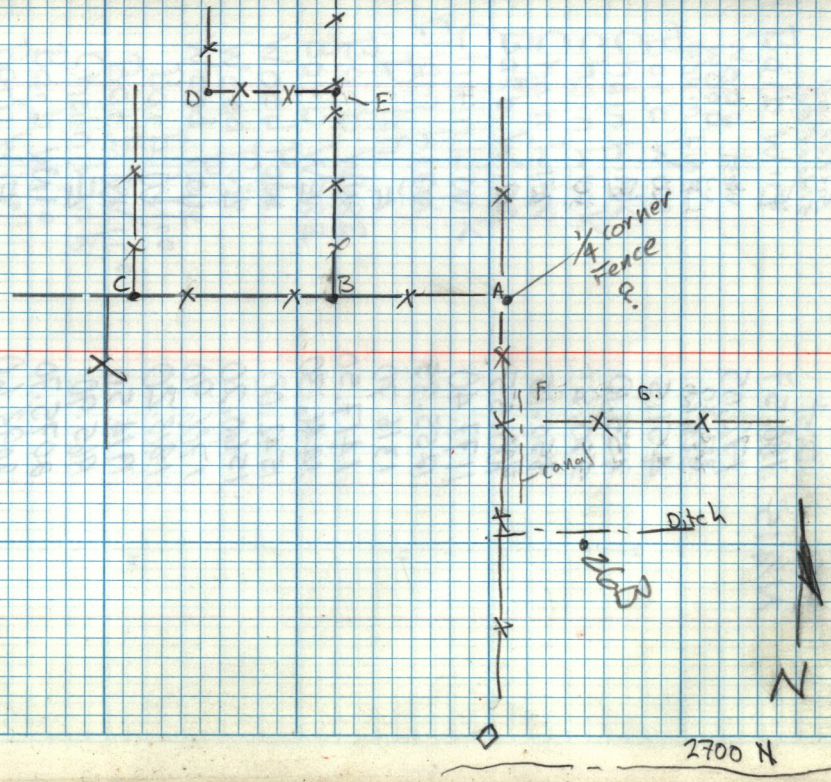
D
E
C
B
A
1/4 corner
Fence
?
F
G.
canal
Ditch
N
2700 N