


Fence cedar & wire Runs N.West. 200.0 To Fence cor. and S.E. 70'

To The Fence cor. From above

East R.O.W. Fence of Canal - has P.I 30' So. and Runs S.E. N. 500'

cedar posts Runs So. 1/2 mile starts at this Point

cedar Post Ext. 100' Runs No. 1/2 mile

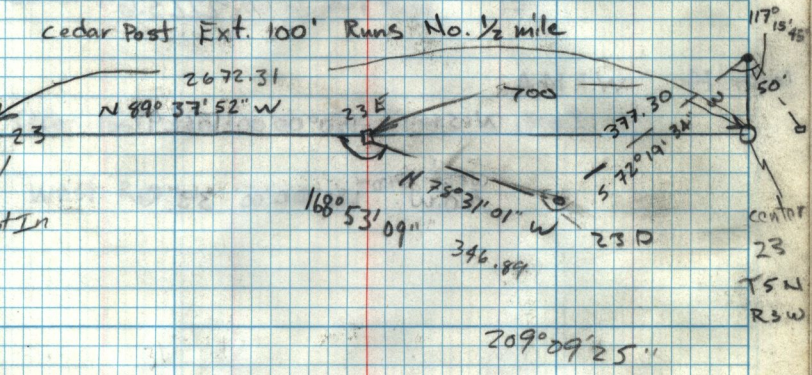

Remains of old Fence Runs E. 1000'

Chain link Fence (Replaces old cedar Post Fence) Fence Runs E. 500' & West 100'

Cedar Post W. 100' E. 200 to chain link to cedar 500' E ±

cedar Post W. 100' E. 100'

cedar Post W. 250' E 2000'