2643.13

(50)

East starts 200' E. & Runs 200 E

Cedar Post West - Runs West 1300 +

Chain link West Runs W. 500'

Chain link East Runs 500' +

chain link East 500 ±

South R.O.W. Fence S500S.

N. R.O.W. Fence S500S

East cedar Post runs E. 400 ±

E. cedar Post Runs E 500'

chain link Fence East 400.0'

Chain link West 500 +

cedar Post East 400'

Chain link West 500'

Cedar Post East 400'

Cedar Post East 400'
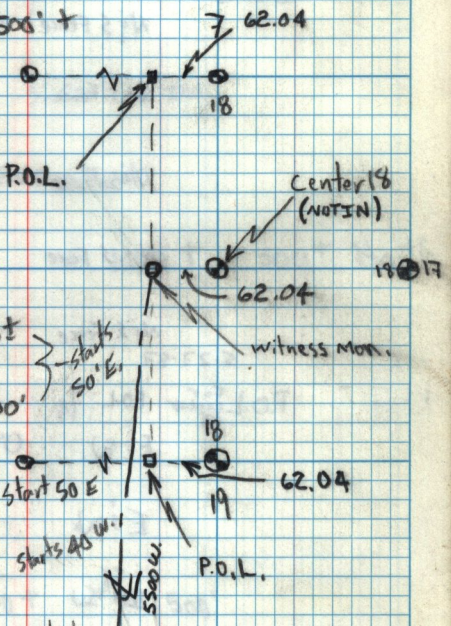
Cedar Post East 400