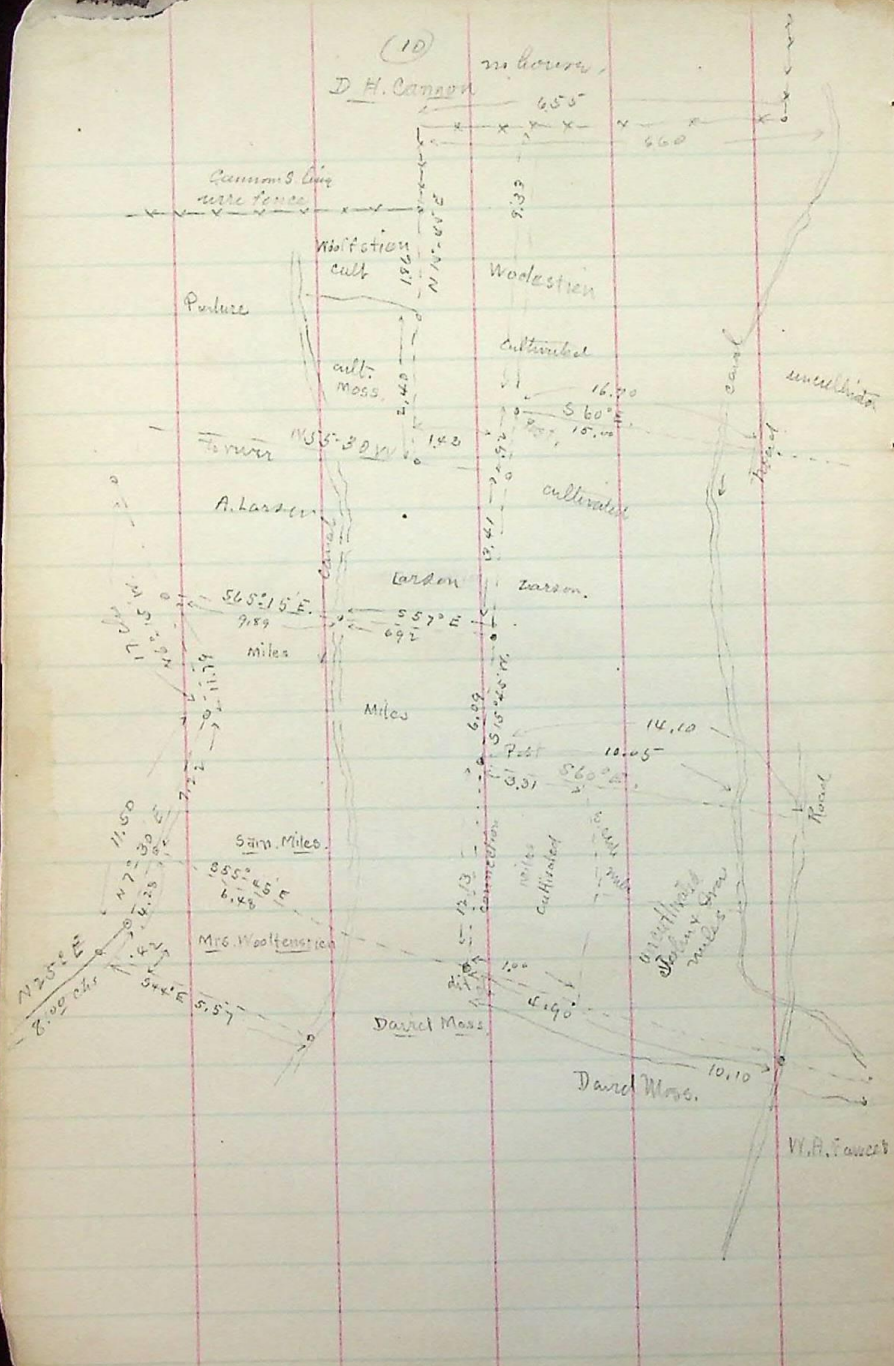
(10)
D. H. Cannon
655
660
Cannon S. line
wire fence
Woolfstien
cult
Wodestien
Pasture
cultivated
cult.
Moss
16.70
S 60° E
15.00
N 55° 30 W
1.42
Forrer
cultivated
A. Larson
Larson
Larson
S 65° 15' E
9.89
S 57° E
692
Miles
Miles
14.10
10.05
S 60° E
3.31
Road
Road
Sam. Miles
S 55° 45' E
6.48
Mrs. Woolfenstien
N 25° E
8.00 chs
S 44° E
5.57
Daird Moss
4.90
10.10
Daird Moss.
W. A. Fawcett
cultivated
Jolly & Gray
miles
cultivated
connection
Road