


(26)

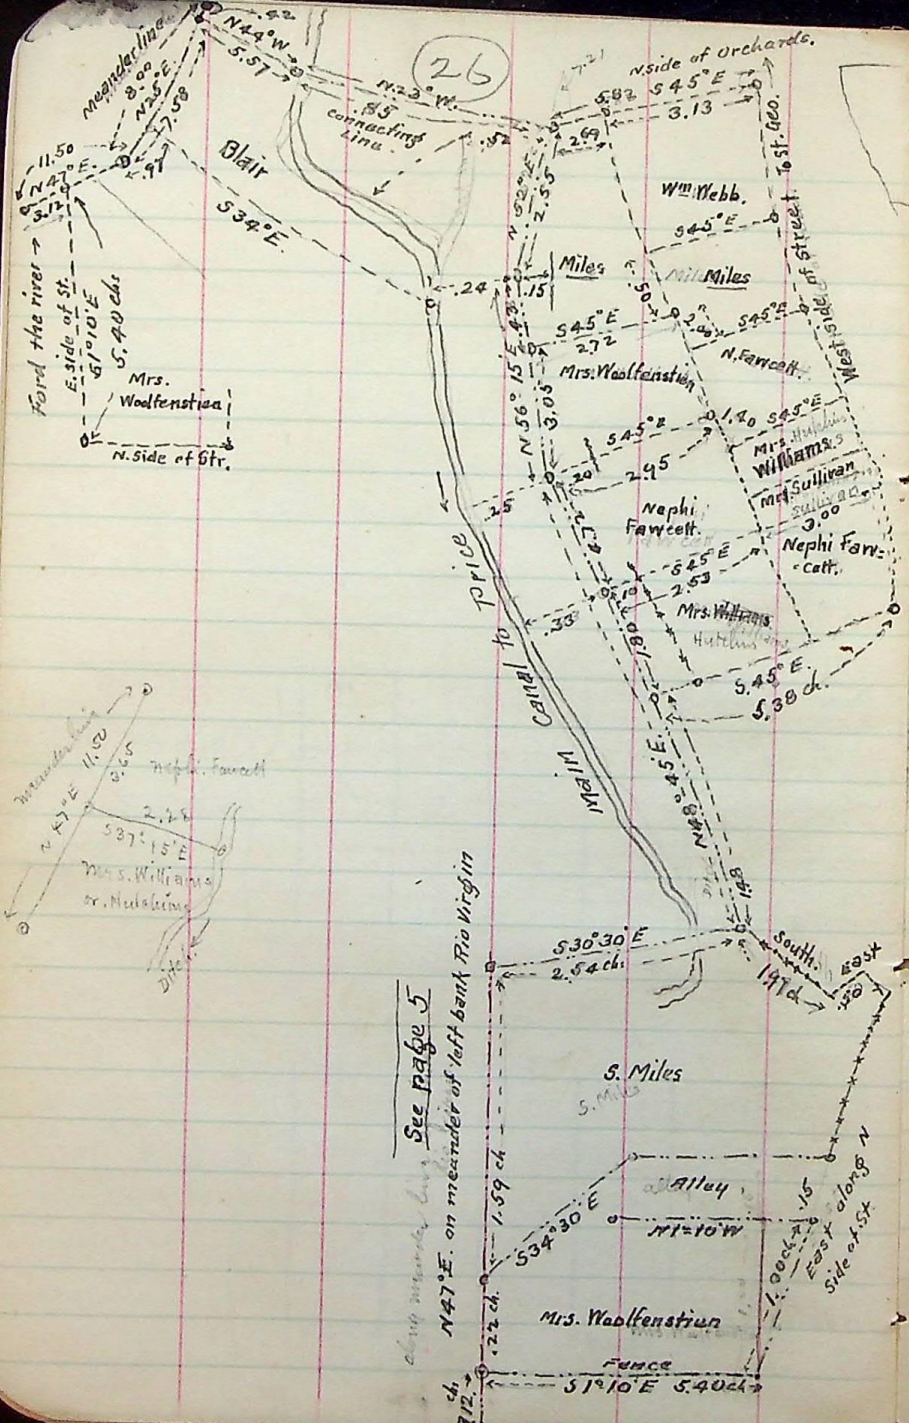

along meander line See page 5

$N 4 7^{\circ} E$ on meander of left bank Rio Virgin